

**APPENDIX J**  
**TOPOGRAPHIC SURVEYS**

## **Appendix J – Topographic Surveys**


### **Table of Contents**

#### ***Sage Surveys***

1. IEL-2 Post-Excavation Topographic Survey
2. IEL-2 Post-Restoration Topographic Survey


#### ***Cal Vada Surveys***

3. Post-Excavation Surveys for ISRA Areas AP/STP-1B, AP/STP-1C-1, AP/STP-1C-2, AP/STP-1E-1, AP/STP-1E-2, AP/STP-1E-3, ELV-1C, ELV-1D, IEL-3, LOX-1B-1, LOX-1B-2, LOX-1B-3, and the Soil Borrow Area

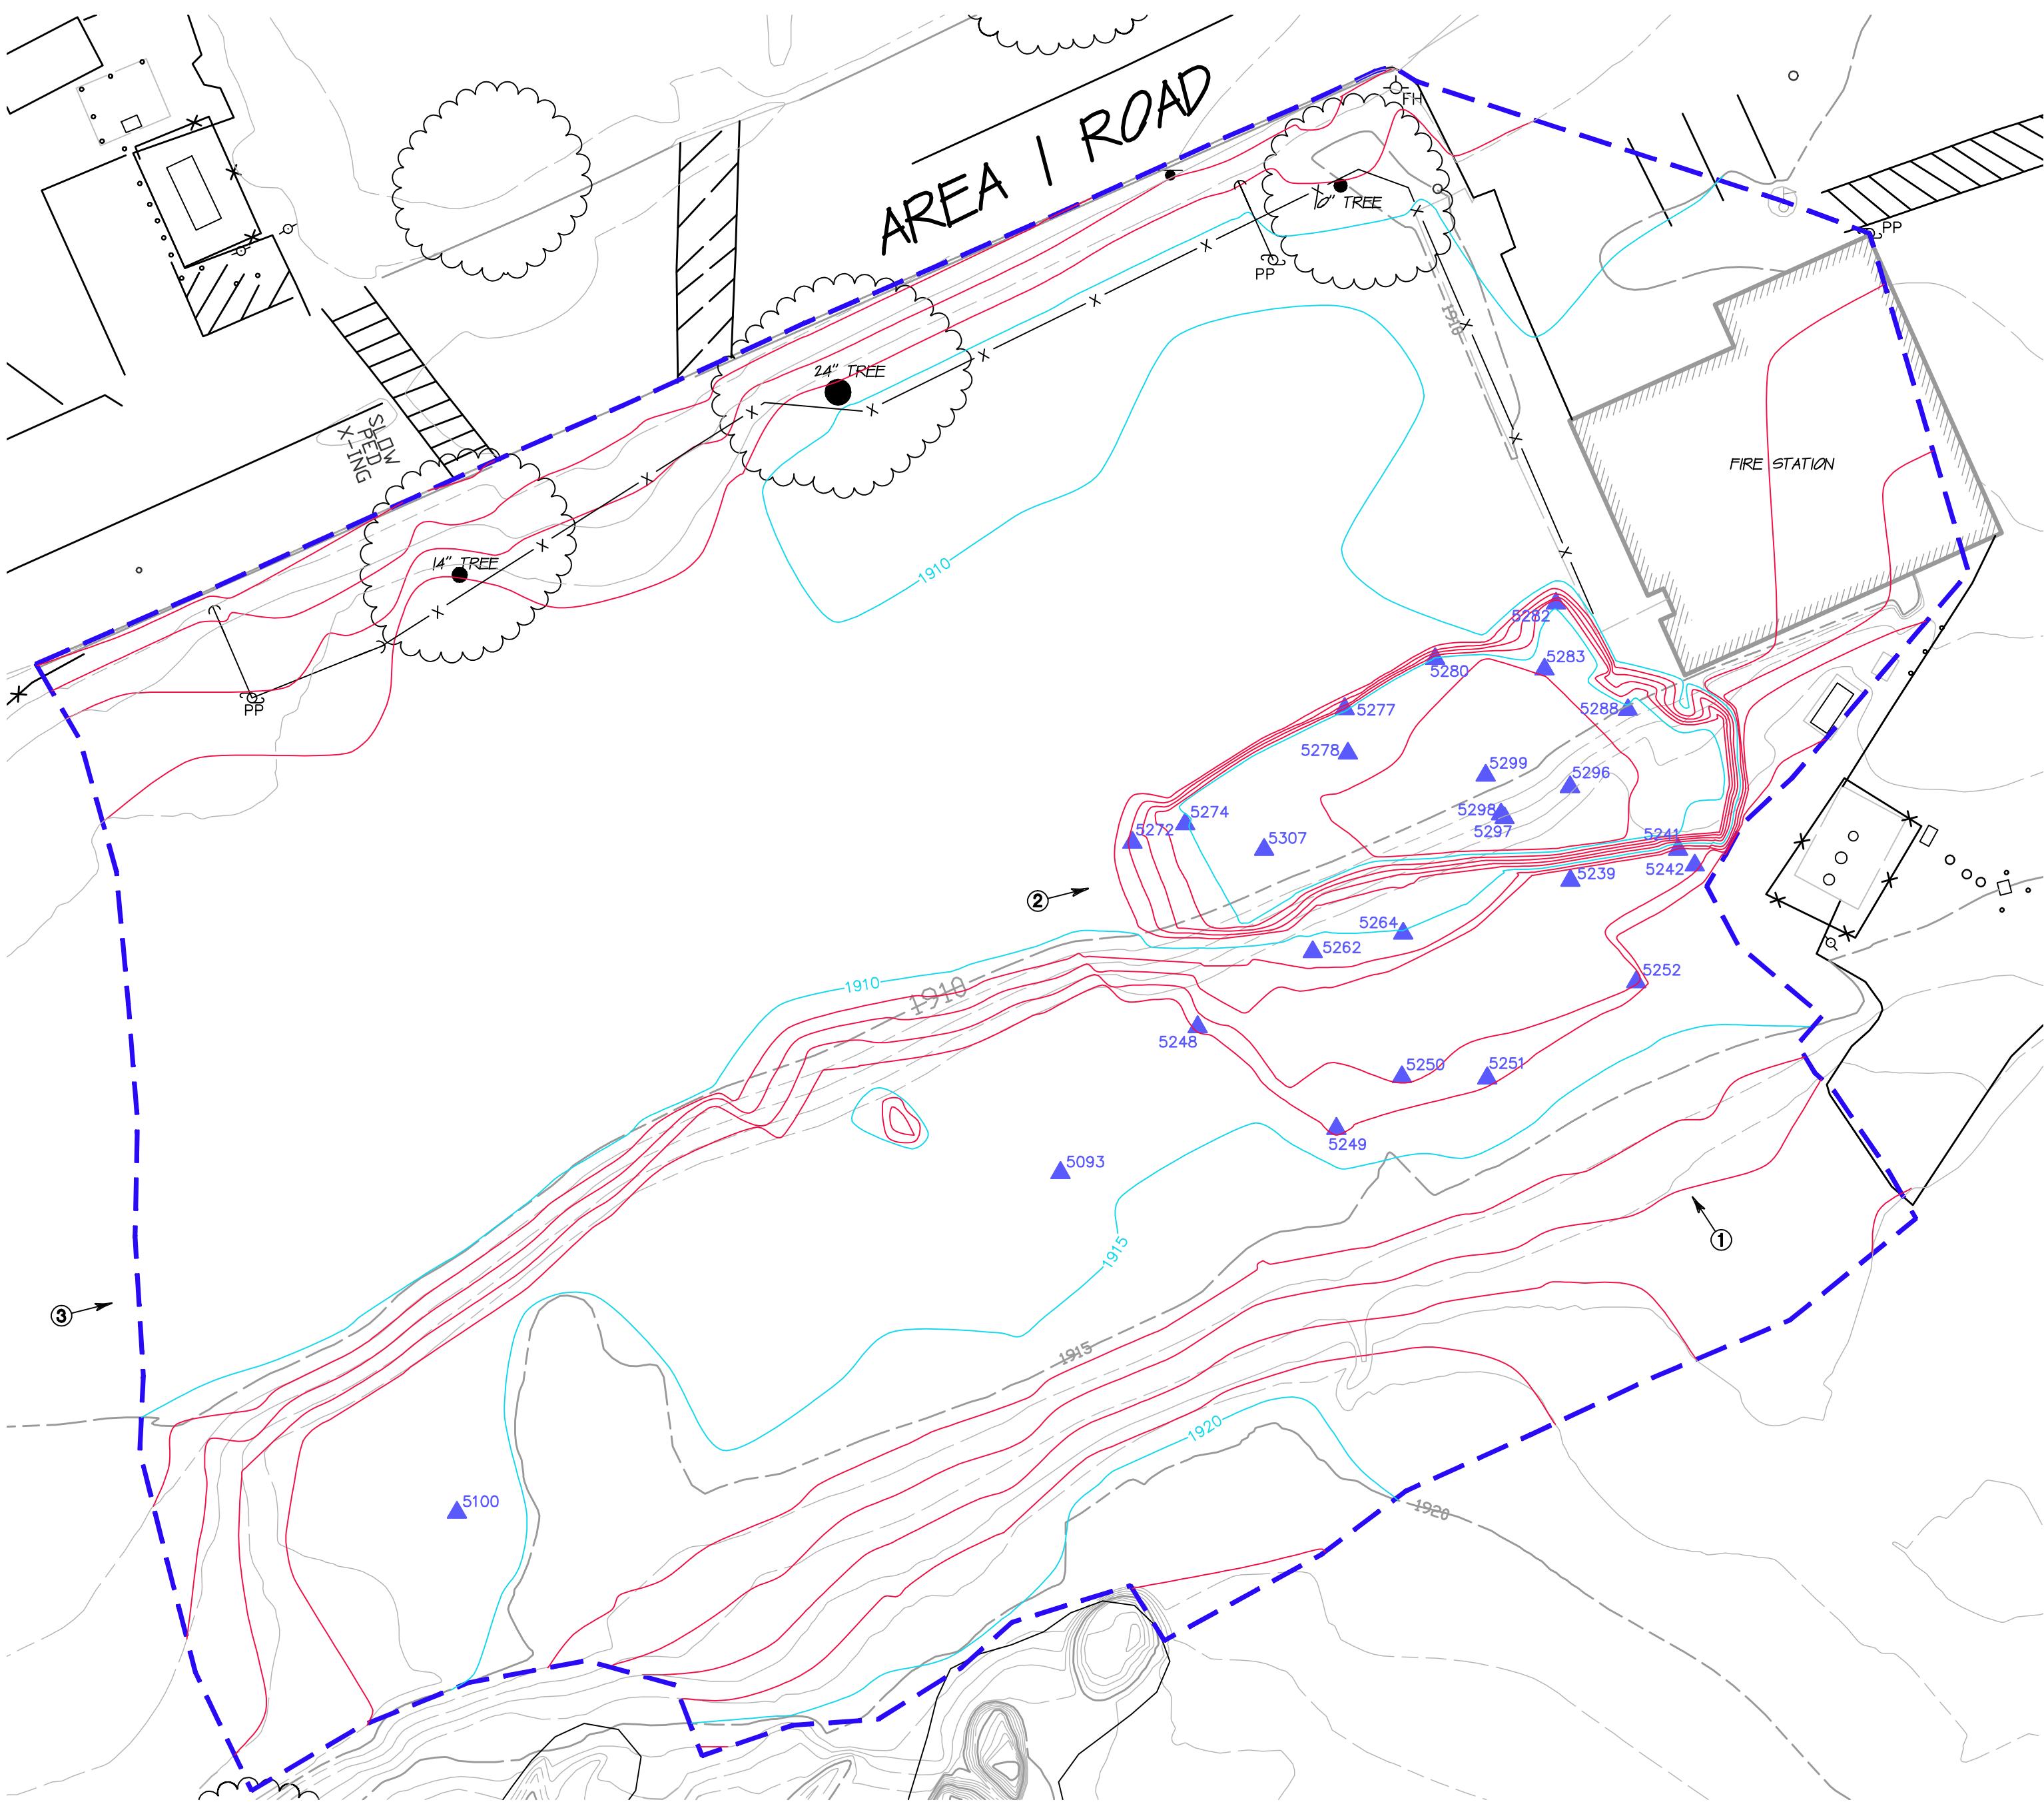

### LEGEND

- 1920 5' CONTOURS (MAY 2011)
- 1' CONTOURS (MAY 2011)
- 5' CONTOURS (JUNE 2010)
- 1' CONTOURS (JUNE 2010)
- SURVEYED EXCAVATION LIMITS
- DIRT ROAD
- POWER POLE
- SIGN
- FLAG POLE
- BRUSH LINE
- TREE
- SAMPLE POINT LOCATION
- ③ PHOTO VIEWPOINT

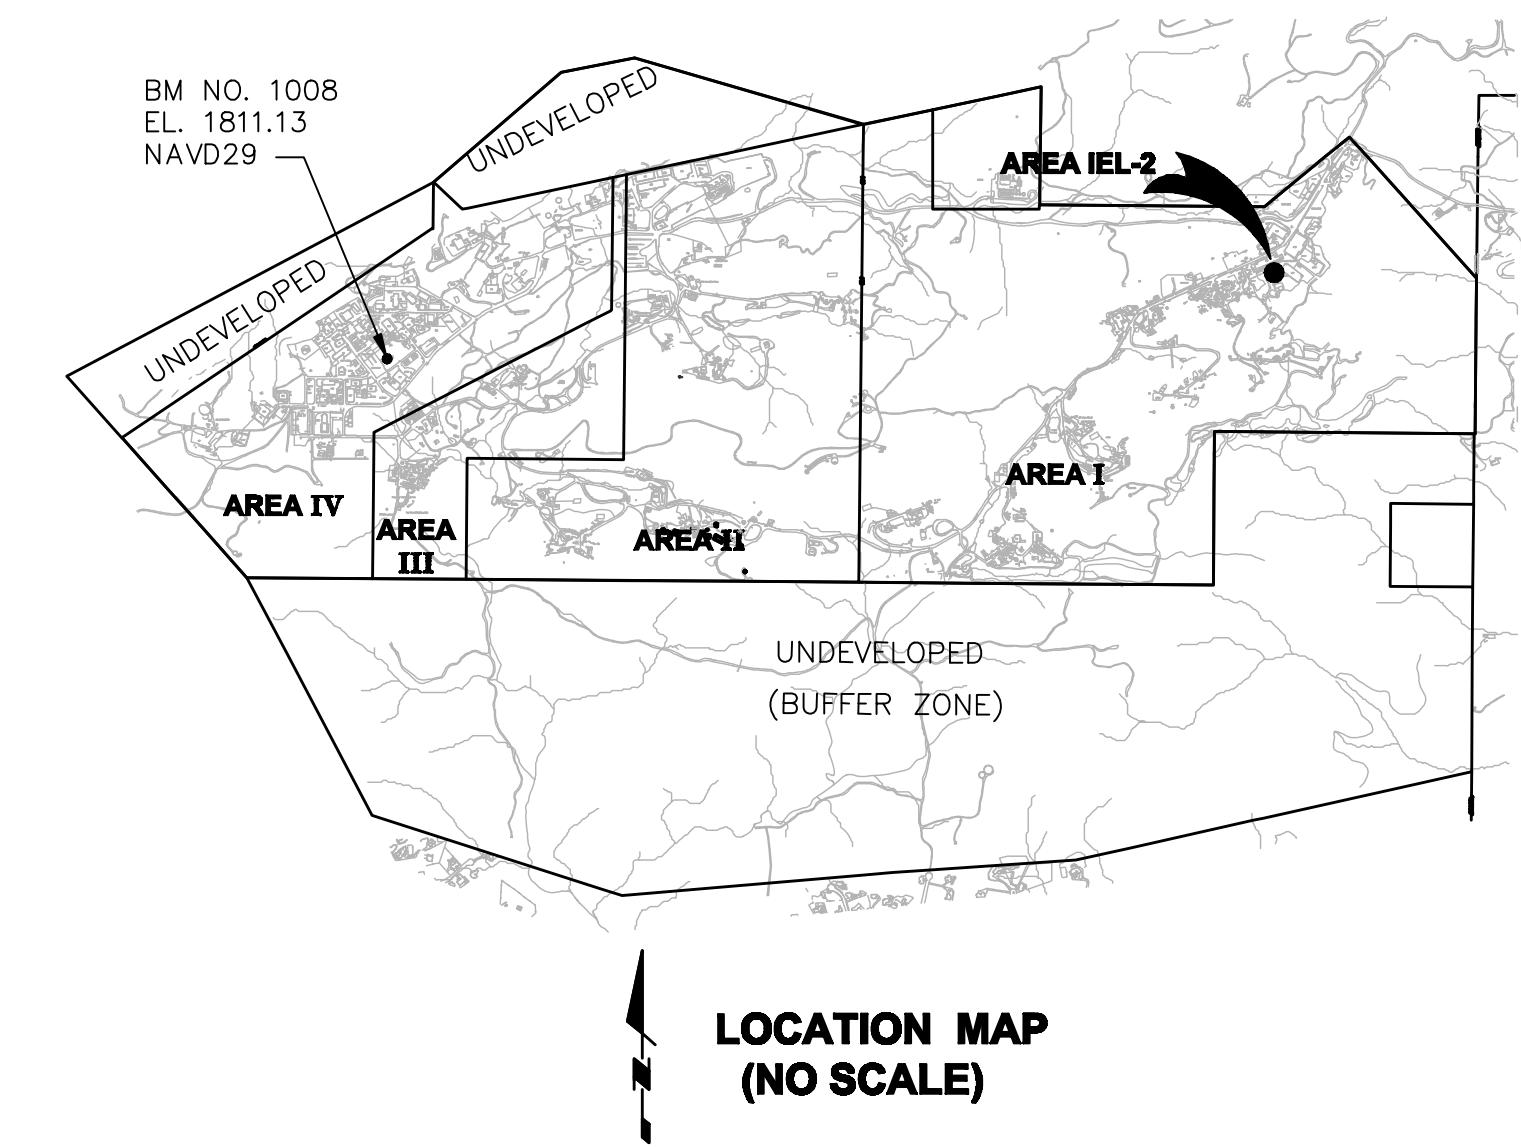

**LOCATION MAP  
(NO SCALE)**

| BOEING SSFL ISRA IEL-2, SAMPLE POINTS  |               |                  |                  |           |             |                            |
|--|---------------|------------------|------------------|-----------|-------------|----------------------------|
| SAGE CONSULTANTS INC.<br>JO: 494-V-2000<br>5800 WOOLSEY CANYON ROAD, CANOGA PARK, CA<br>SHEET 1 of 1<br>Date: 06/07/2011 |               |                  |                  |           |             |                            |
| Point ID   | NAME          | North Latitude * | West Longitude * | NAVD 88** | Northing*** | Eastng**  GROUND ELEV.**** |
| 5093   | ILBS92        | 34.14-04.68586   | 118-40-33.42340  | 1917.22   | 268029.4108 | 1795968.4539 1914.58       |
| 5100   | ILBS0146      | 34.14-04.64267   | 118-40-34.54336  | 1916.93   | 267976.3153 | 1795874.0649 1914.29       |
| 5239   | ILBS029AS001  | 34.14-05.14312   | 118-40-32.47717  | 1914.81   | 269075.1090 | 1796048.2076 1912.17       |
| 5241   | ILET0102S001  | 34-14-05.19225   | 118-40-32.27727  | 1914.87   | 268079.9524 | 1796065.0237 1912.24       |
| 5242   | ILBS02AS001   | 34-14-05.16774   | 118-40-32.24618  | 1915.26   | 268077.4679 | 1796067.6172 1912.62       |
| 5248   | ILBS0294AS001 | 34-14-04.91277   | 118-40-33.16974  | 1916.21   | 268052.2141 | 1795969.9051 1913.57       |
| 5249   | ILBS0234AS001 | 34-14-04.65690   | 118-40-32.91027  | 1916.23   | 268036.3119 | 1796011.5829 1913.59       |
| 5250   | ILET0100S001  | 34-14-04.83745   | 118-40-32.78892  | 1915.54   | 268044.3864 | 1796021.8260 1912.90       |
| 5251   | ILBS0228AS001 | 34-14-04.83666   | 118-40-32.62972  | 1916.06   | 268042.2162 | 1796035.1912 1913.42       |
| 5252   | ILBS0229AS001 | 34-14-04.98674   | 118-40-32.35356  | 1915.54   | 268059.2323 | 1796058.4791 1912.90       |
| 5262   | ILET0104S001  | 34-14-05.02997   | 118-40-32.5623   | 1913.0    | 268063.9411 | 1796007.9103 1910.36       |
| 5264   | ILET0103S001  | 34-14-05.05966   | 118-40-32.78830  | 1912.6    | 268066.8489 | 1796022.0289 1910.06       |
| 5272   | ILBS0235S001  | 34-14-05.19731   | 118-40-33.29353  | 1910.32   | 268081.0466 | 1795979.7052 1907.68       |
| 5274   | ILET0106S001  | 34-14-05.22629   | 118-40-33.19538  | 1907.71   | 268083.9207 | 1795987.9654 1905.07       |
| 5277   | ILBS0169AS001 | 34-14-05.40632   | 118-40-32.89999  | 1908.95   | 268101.9527 | 1796012.8878 1906.31       |
| 5278   | ILET0108S001  | 34-14-05.33732   | 118-40-32.89323  | 1907.05   | 268094.9739 | 1796013.4088 1904.42       |
| 5280   | ILBS0297AS001 | 34-14-05.48469   | 118-40-32.73181  | 1907.44   | 268109.7805 | 1796027.0611 1904.80       |
| 5282   | ILBS0329AS001 | 34-14-05.57163   | 118-40-32.50786  | 1907.20   | 268118.4420 | 1796045.9220 1904.56       |
| 5283   | ILET0110S001  | 34-14-05.46963   | 118-40-32.52811  | 1906.71   | 268108.1426 | 1796044.1524 1904.07       |
| 5287   | ILET0113S001  | 34-14-05.43284   | 118-40-32.34780  | 1907.93   | 268104.3224 | 1796059.2660 1905.29       |
| 5288   | ILET0109S001  | 34-14-05.40764   | 118-40-32.37250  | 1907.17   | 268101.7888 | 1796057.1748 1904.53       |
| 5296   | ILET0114      | 34-14-05.28791   | 118-40-32.47948  | 1905.69   | 268089.7461 | 1796048.1121 1903.05       |
| 5297   | ILET0115      | 34-14-05.23896   | 118-40-32.60995  | 1906.88   | 268084.9672 | 1796037.8908 1903.25       |
| 5298   | ILET0112S001  | 34-14-05.24498   | 118-40-32.60768  | 1906.94   | 268085.4734 | 1796037.3192 1903.30       |
| 5299   | ILET0111S001  | 34-14-05.30470   | 118-40-32.63649  | 1906.29   | 268091.3324 | 1796034.9410 1903.65       |
| 5307   | ILET0107S001  | 34-14-05.16758   | 118-40-33.04801  | 1906.89   | 268079.9253 | 1796000.3121 1904.25       |

\* degrees, minutes, seconds; NAD 83  
\*\* SPC, CA Zone 5, Survey Feet, NAD 27  
\*\*\* NAVD 88; north side surface casing  
\*\*\*\* NAVD 29; north side

### SITE VOLUMES (Cubic Yards)


| Site         | Stratum | Surf1             |           | Cut               | Fill                          | Net                           | Method |
|--------------|---------|-------------------|-----------|-------------------|-------------------------------|-------------------------------|--------|
|              |         | PostEx            | EG-Aerial |                   |                               |                               |        |
| LDD IEL 2000 |         | 918<br>977<br>975 |           | 492<br>553<br>552 | 427 (C)<br>424 (C)<br>423 (C) | Grid<br>Composite<br>End area |        |



**VIEW 1**  
LOOKING NORTHWEST

**VIEW 2**  
LOOKING EAST

**VIEW 3**  
LOOKING NORTHEAST

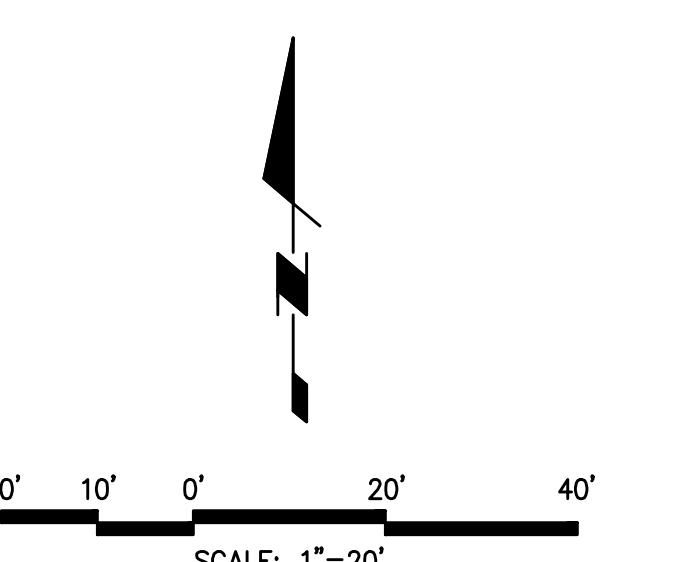

**SAGE** Consultants, Inc.  
LAT 34°-13'-00" N LONG 119°-02'-40" W ELEV 55.458m  
Surveyors • Application Developers • GIS Integrators • Engineers  
1978 Ventura Blvd., CAMARILLO CA 93010-7847  
Tel. (805) 482-6088 • Fax (805) 389-9815  
[www.sagecon.com](http://www.sagecon.com)

*Robert E. Littell*  
ROBERT E. LITTELL  
REGISTERED PROFESSIONAL ENGINEER  
No. 13395  
Exp. 3-31-2013  
CIVIL  
STATE OF CALIFORNIA

ROBERT E. LITTELL RCE 13395


### THE BOEING COMPANY ISRA IEL-2 POST EXCAVATION EXHIBIT

JO 494-V-2000

BENCH MARK:


FOUND BRASS DISK STAMPED "N 22688.45 E 12152.65 ELEV 1813.75 LS 2957" SET IN TOP WEST EDGE OF ROCK OUTCROPPING LOCATED IN VACANT FIELD NORTH OF ASPHALT DRIVE NORTH OF BUILDING 110.

COORDINATES DERIVED FROM BOEING 1992 TOPOGRAPHIC MAP (NAVD27 NAVD29 FEET):  
N 266917.4900  
E 1785312.1200  
ELEV 1811.13

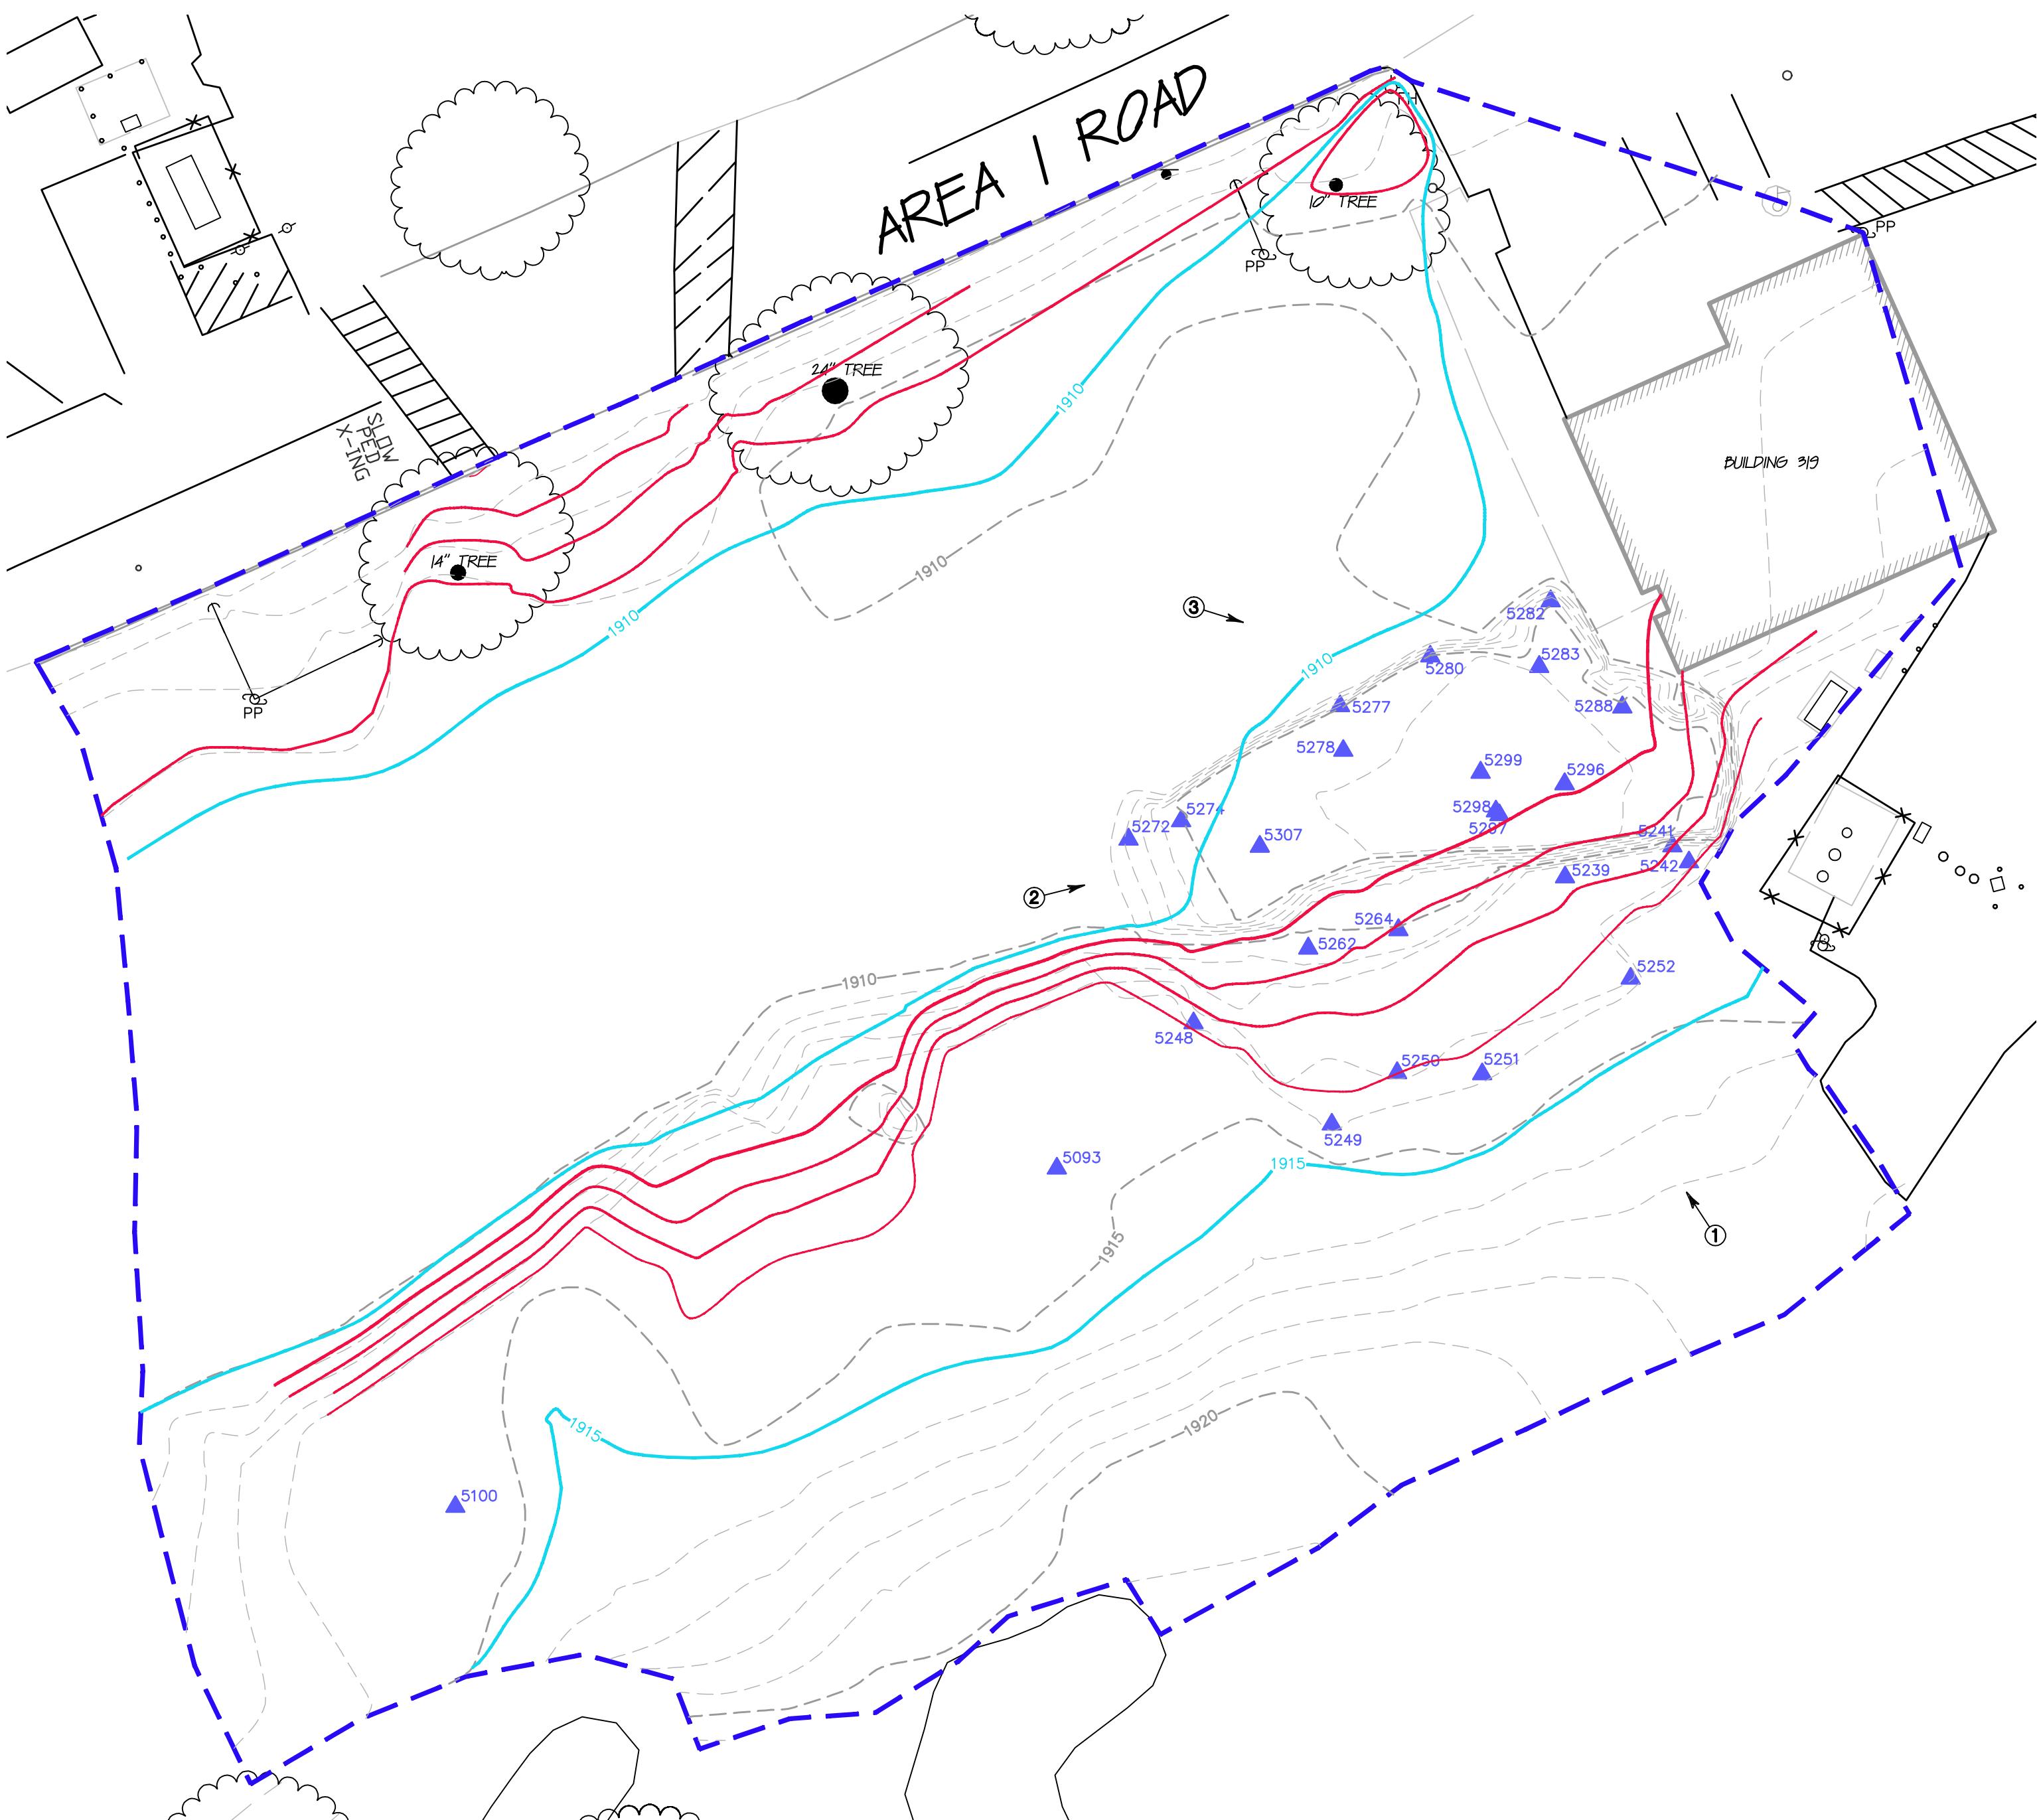

### LEGEND

- 1920 5' CONTOURS (JUNE 2011)
- 1' CONTOURS (JUNE 2011)
- 5' CONTOURS (MAY 2011)
- 1' CONTOURS (MAY 2011)
- SURVEYED EXCAVATION LIMITS
- DIRT ROAD
- PP POWER POLE
- SIGN SIGN
- FLAG POLE FLAG POLE
- BRUSH LINE BRUSH LINE
- TREE TREE
- △ SAMPLE POINT LOCATION
- ③ PHOTO VIEWPOINT

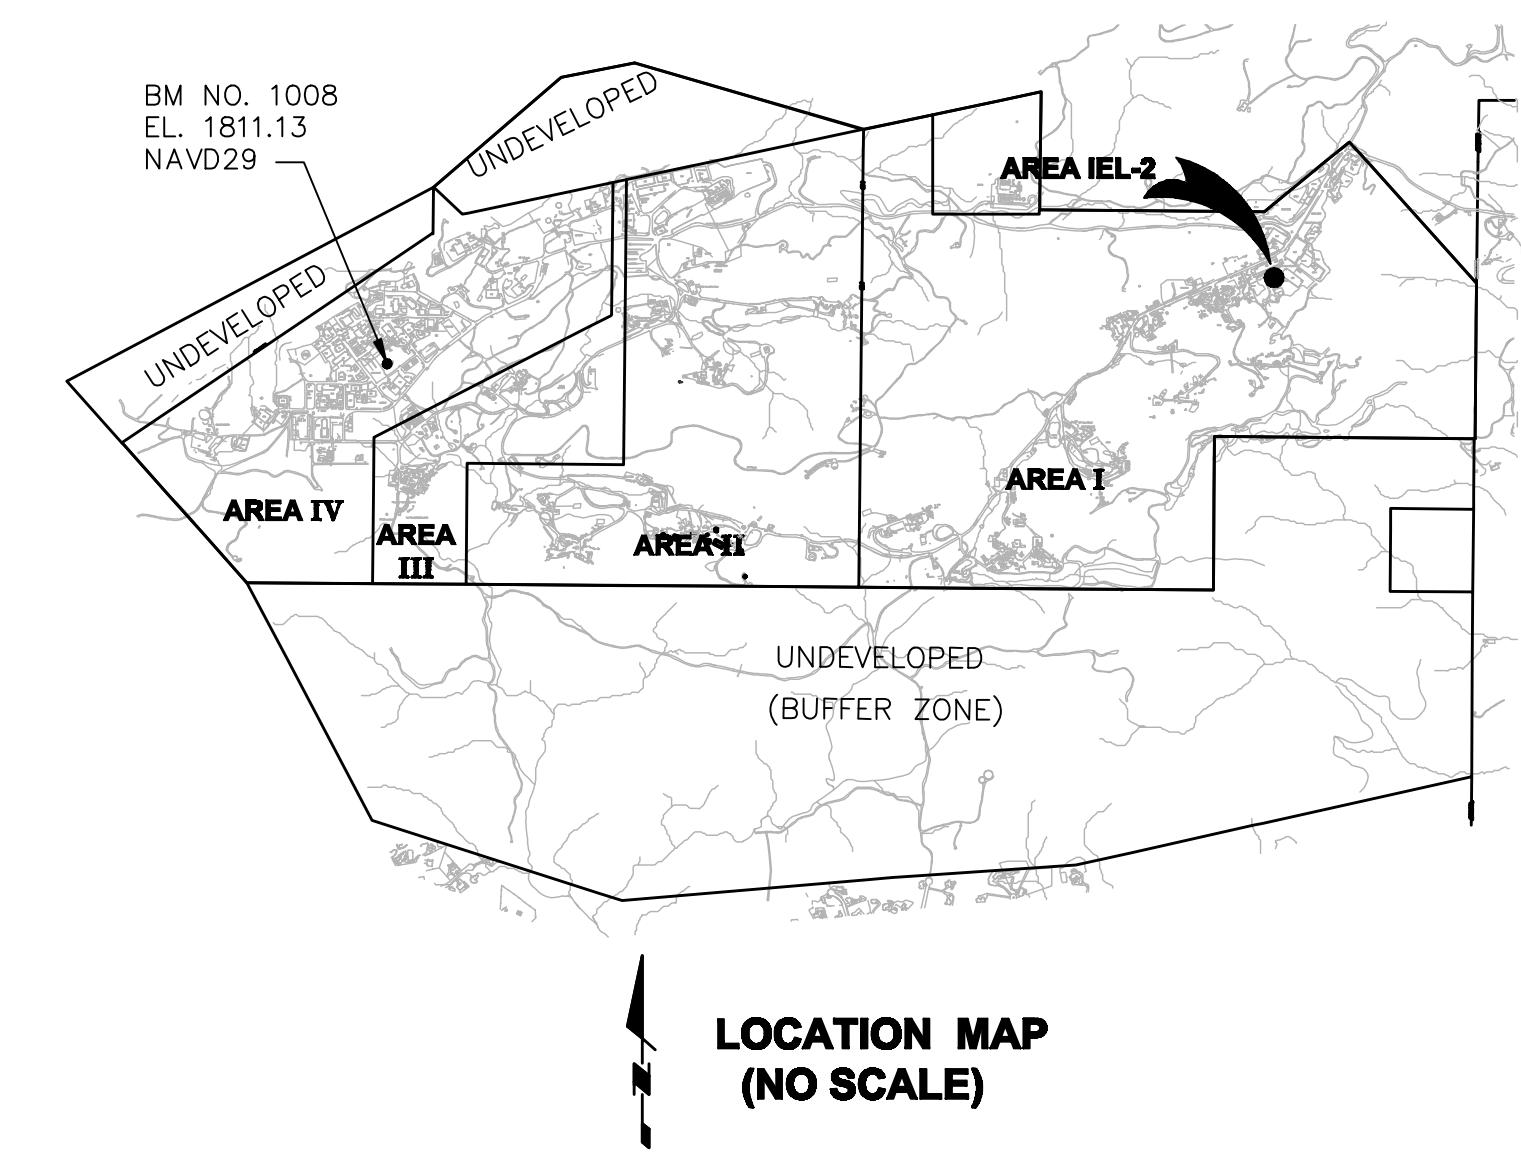

**LOCATION MAP  
(NO SCALE)**

| BOEING SSFL ISRA IEL-2, SAMPLE POINTS  |               |                  |                                |                          |                          |                 |
|--|---------------|------------------|--------------------------------|--------------------------|--------------------------|-----------------|
| SAGE CONSULTANTS INC.<br>JO: 494-V-2000<br>5800 WOOLSEY CANYON ROAD, CANOGA PARK, CA<br>SHEET 1 of 1<br>Date: 06/07/2011 |               |                  |                                |                          |                          |                 |
| Point ID   | NAME          | North Latitude * | West Longitude *<br>NAVD 88*** | Northing**<br>NAVD 88*** | Eastino**<br>NAVD 29**** | GROUNDELEV.**** |
| 5093   | ILBS92        | 34.14-04.68586   | 118-40-33.42340                | 1917.22                  | 268029.4108              | 1795968.4539    |
| 5100   | ILBS0146      | 34.14-04.64267   | 118-40-34.54336                | 1916.93                  | 267976.3153              | 1795874.0649    |
| 5239   | ILBS0294AS001 | 34.14-05.14312   | 118-40-32.47717                | 1914.81                  | 269075.1090              | 1796048.2076    |
| 5241   | ILET0102S001  | 34-14-05.19235   | 118-40-32.27727                | 1914.87                  | 265079.9524              | 1796065.0237    |
| 5242   | ILBS02AS001   | 34-14-05.16774   | 118-40-32.24618                | 1915.26                  | 265077.4679              | 1796067.6172    |
| 5248   | ILBS0294AS001 | 34-14-04.91277   | 118-40-33.16934                | 1916.21                  | 268052.2141              | 1795969.9051    |
| 5249   | ILBS0234AS001 | 34-14-04.65690   | 118-40-32.91027                | 1916.23                  | 268036.3119              | 1796011.5829    |
| 5250   | ILET0100S001  | 34-14-04.83745   | 118-40-32.78892                | 1915.54                  | 268044.3864              | 1796021.8260    |
| 5251   | ILBS0228AS001 | 34-14-04.83666   | 118-40-32.62972                | 1916.06                  | 268044.2162              | 1796035.1912    |
| 5252   | ILBS0229AS001 | 34-14-04.98674   | 118-40-32.35356                | 1915.54                  | 268059.2323              | 1796058.4791    |
| 5262   | ILET0104S001  | 34-14-05.02997   | 118-40-32.5623                 | 1913.00                  | 268063.9411              | 1796007.9103    |
| 5264   | ILET0103S001  | 34-14-05.05966   | 118-40-32.78830                | 1912.60                  | 268066.8489              | 1796022.0289    |
| 5272   | ILBS0235S001  | 34-14-05.19731   | 118-40-33.29353                | 1910.32                  | 268081.0466              | 1795979.7052    |
| 5274   | ILET0106S001  | 34-14-05.22629   | 118-40-33.19538                | 1907.71                  | 268083.9207              | 1795987.9654    |
| 5277   | ILBS0169AS001 | 34-14-05.40632   | 118-40-32.89999                | 1908.95                  | 268101.9527              | 1796012.8878    |
| 5278   | ILET0108S001  | 34-14-05.33732   | 118-40-32.89323                | 1907.05                  | 268094.9739              | 1796013.4088    |
| 5280   | ILBS0297AS001 | 34-14-05.48469   | 118-40-32.73181                | 1907.44                  | 268109.7805              | 1796027.0611    |
| 5282   | ILBS0329AS001 | 34-14-05.57163   | 118-40-32.50786                | 1907.20                  | 268118.4420              | 1796045.9220    |
| 5283   | ILET0110S001  | 34-14-05.46963   | 118-40-32.52811                | 1906.71                  | 268108.1426              | 1796044.1524    |
| 5287   | ILET0113S001  | 34-14-05.43284   | 118-40-32.34780                | 1907.93                  | 268104.3224              | 1796059.2660    |
| 5288   | ILET0109S001  | 34-14-05.40764   | 118-40-32.37250                | 1907.17                  | 268101.7888              | 1796057.1748    |
| 5296   | ILET0114      | 34-14-05.28791   | 118-40-32.47948                | 1905.69                  | 268089.7461              | 1796048.1121    |
| 5297   | ILET0115      | 34-14-05.23896   | 118-40-32.60995                | 1906.88                  | 268084.9672              | 1796037.8908    |
| 5298   | ILET0112S001  | 34-14-05.24498   | 118-40-32.60768                | 1906.94                  | 268085.4794              | 1796037.3192    |
| 5299   | ILET0111S001  | 34-14-05.30470   | 118-40-32.63649                | 1906.29                  | 268091.3324              | 1796034.9410    |
| 5307   | ILET0107S001  | 34-14-05.16758   | 118-40-33.04801                | 1906.89                  | 268079.9253              | 1796000.3121    |

\* degrees, minutes, seconds; NAD 83  
\*\* SPC, CA Zone 5, Survey Feet, NAD 27  
\*\*\* NAD 88: north side surface casing  
\*\*\*\* NAD 29: north side

### SITE VOLUMES (Cubic Yards)

| Site  | Site Volume Table: Unadjusted |        |          | Method   |
|-------|-------------------------------|--------|----------|--|
|       | Stratum                       | Surf1  | Surf2    |  |
| IEL-2 | AsBuilt                       | PostEx | As-Built |  |
|       |                               |        |          | 275<br>301<br>307  |
|       |                               |        |          | 759<br>852<br>858  |
|       |                               |        |          | 484 (F)<br>551 (F)<br>551 (F)<br>Grid<br>Composite<br>End-area |




**VIEW 1**  
LOOKING NORTH



**VIEW 2**  
LOOKING EAST



**VIEW 3**  
LOOKING SOUTHEAST

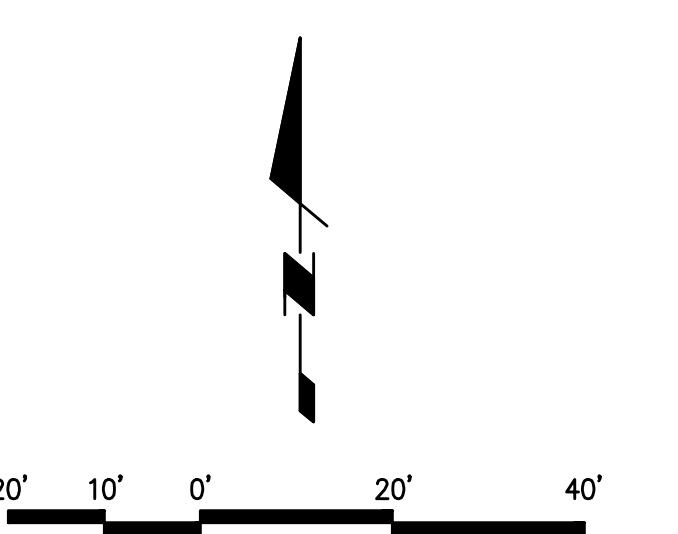

SCALE: 1'=20'

### NOTES

PURPOSE: THE PURPOSE OF THIS DRAWING IS TO SHOW AS-BUILT TOPOGRAPHY AND CALCULATE THE VOLUME OF FILL SOIL AS OF JUNE 2011.

NOTES: 1: AS-BUILT SURFACE SURVEYED JUNE 17, 2011.

2: VOLUMES CALCULATED USING AUTODESK LAND DESKTOP SOFTWARE.

THE TOPOGRAPHIC INFORMATION SHOWN HEREON WAS PREPARED BY GOLDEN STATE AERIAL SURVEYS. THIS MAP WAS PREPARED AT A SCALE OF 1" = 40' WITH A ONE FOOT CONTOUR INTERVAL, PREPARED FROM AERIAL PHOTOGRAPHY DATED JUNE 2, 2010. THE POST EXCAVATION DATA WAS PREPARED FROM A FIELD SURVEY DATED MAY 27, 2011.

**SAGE** Consultants, Inc.  
LAT 34°-13'-00" N LONG 119°-02'-40" W ELEV 55.458m  
Surveyors • Application Developers • GIS Integrators • Engineers  
1978 Ventura Blvd., CAMARILLO CA 93010-7847  
Tel. (805) 462-6088 • Fax (805) 389-9815  
[www.sagecon.com](http://www.sagecon.com)

*Robert E. Littell*  
ROBERT E. LITTELL  
REGISTERED PROFESSIONAL ENGINEER  
No. 13395  
Exp. 3-31-2013  
CIVIL  
STATE OF CALIFORNIA

**THE BOEING COMPANY**  
**ISRA IEL-2**  
**AS-BUILT EXCAVATION**  
**EXHIBIT**

5800 WOOLSEY CANYON ROAD  
CANOGA PARK, CA 91344-1148

JO 494-V-2000

BENCH MARK:

FOUND BRASS DISK STAMPED "N 22688.45 E 12152.65 ELEV 1813.75 LS 2957" SET IN TOP WEST EDGE OF ROCK OUTCROPPING LOCATED IN VACANT FIELD NORTH OF ASPHALT DRIVE NORTH OF BUILDING 110.

COORDINATES DERIVED FROM BOEING 1992 TOPOGRAPHIC MAP (NAD27 NAVD29 FEET):  
N 266917.4900  
E 1785312.1200  
ELEV 1811.13